



7985 Courtyard Plaza, Suite 101
 Memphis, TN 38119
 Ph: 901.380.4675

TO: Power Construction
 ATTN: Crystal Herrera

Subcontract #:
 Change Order #: #009 Bulletin#7 - Rev.1
 Date: 5/5/2026
 Project: West Lafayette, IN - Hub Chauncey

Blake Solutions, Inc. is submitting a Request for Change Order for the following changes

Item	Detail	Price
1	Sidesplash @ Vanity - Upgrade Addition 163 pieces	\$ 9,140.00
2		
3		
4		
5		
6		
7		
8		
9		
10		
11		
12		
	ESTIMATED TAX	Included
	ESTIMATED FREIGHT	Included
	TOTAL	\$ 9,140.00

The original contract amount was:	\$ 4,861,605.00
Net change by previously authorized Change Orders:	\$ 669,345.00
The Contract amount prior to this Change Order was:	\$ 5,530,950.00
The Contract will be increased/decreased by this Change Order in the amount of:	\$ 9,140.00
The new Contract amount, including this Change Order will be:	\$ 5,540,090.01

CONTRACTOR**SUBCONTRACTOR**

Blake Solutions, Inc
 7985 Courtyard Plaza, Suite 101
 Memphis, TN 38119

Signature

Signature

By

By

Date

Date

RFI detail

#498 Upgrade Unit Bathroom - Side Splash For Record



Status	Closed
Created on	Nov 21, 2025 by Sam Plessinger (POWER CONSTRUCTION COMPANY LLC [GP])
RFI type	RFI
Ball in court	Sam Plessinger (POWER CONSTRUCTION COMPANY LLC [GP])
Answered	Jan 27, 2026 by Nishith Shah (ANTUNOVICH ASSOCIATES)

Question

Per email conversation on 11/14: All upgraded bathrooms should continue tile work for the sidesplash of the countertops. The height must remain consistent around the sides of the vanity as shown in the reference picture below, and should never exceed 3'-2" as indicated on detail 5/A5.22.

Official response

Nishith Shah (ANTUNOVICH ASSOCIATES): Upgrade unit bathrooms are to receive a quartz sidesplash and backsplash. No tile at the quartz countertop - similar to the standard units.
At the toilet there will be tile that goes up to the underside of the shelving.
See markup on detail 5/A5.22.
The architect's responses to the contractor's questions or request for information assumes this to be a clarification and within the GMP contract amount. If there are any cost changes anticipated, please inform the owner immediately per the terms of the contract.
- N Shah (Antunovich) 01/27/2026
*By **Nishith Shah** (ANTUNOVICH ASSOCIATES) - Jan 27, 2026, 10:04 AM CST*

Official response attachments

[A5.22 MARKUP.PDF](#), Jan 27, 2026, 10:04 AM CST

References and Attachments

Files (2)

• [GetAttachmentThumbnail.jpg](#)

• [Upgrade Bathroom Sidesplash Clarification - Email 11.14.25.pdf](#)

Sheets (2)

- [A5.22](#)
- [A5.23](#)

Impact


Cost impact	Unknown
Schedule impact	Unknown

Other attributes


Priority	High
Discipline	-
Location	-
Co-reviewer(s)	-

Activities	By	At
Sam Plessinger changed the status from  Open Answered to  Closed Official response: Nishith Shah (ANTUNOVICH ASSOCIATES): Upgrade unit bathrooms are to receive a quartz sidesplash and backsplash. No tile at the quartz countertop - similar to the standard units. At the toilet there will be tile that goes up to the underside of the shelving. See markup on detail 5/A5.22. The architect's responses to the contractor's questions or request for information assumes this to be a clarification and within the GMP contract amount. If there are any cost changes anticipated, please inform the owner immediately per the terms of the contract. - N Shah (Antunovich) 01/27/2026 changed the official response attachment to: A5.22 MARKUP.PDF.	Sam Plessinger	Jan 29, 2026, 4:44 PM CST
Nishith Shah changed the status from  Open In Review to  Open Answered set Ball in court to Sam Plessinger (POWER CONSTRUCTION COMPANY LLC [GP])	Nishith Shah	Jan 27, 2026, 10:04 AM CST
Nishith Shah added a response: Upgrade unit bathrooms are to receive a quartz sidesplash and backsplash. No tile at the quartz countertop - similar to the standard units. At the toilet there will be tile that goes up to the underside of the shelving. See markup on detail 5/A5.22. The architect's responses to the contractor's questions or request for information assumes this to be a clarification and within the GMP contract amount. If there are any cost changes anticipated, please inform the owner immediately per the terms of the contract. - N Shah (Antunovich) 01/27/2026 added the response attachment to: A5.22 MARKUP.PDF.	Nishith Shah	Jan 27, 2026, 10:04 AM CST
Sam Plessinger added a reference to a File Upgrade Bathroom Sidesplash Clarification - Email 11.14.25.pdf	Sam Plessinger	Nov 21, 2025, 12:22 PM CST
Sam Plessinger added a reference to a File GetAttachmentThumbnail.jpg	Sam Plessinger	Nov 21, 2025, 12:22 PM CST
Sam Plessinger added a reference to a Sheet A5.23	Sam Plessinger	Nov 21, 2025, 12:22 PM CST
Sam Plessinger added a reference to a Sheet A5.22	Sam Plessinger	Nov 21, 2025, 12:22 PM CST
Sam Plessinger (POWER CONSTRUCTION COMPANY LLC [GP]) created this RFI in  Open In Review status and set Ball in court to Nishith Shah (ANTUNOVICH ASSOCIATES).	Sam Plessinger	Nov 21, 2025, 12:22 PM CST


UPGRADED - MANSION UNIT FINISH SCHEDULE							
TAG	LOCATION	DESCRIPTION	MANUFACTURER	MODEL/ STYLE	COLOR/ FINISH	SIZE	COMMENTS
RESILIENT FLOORING							
LVT-01	LIVING, KITCHEN	LUXURY VYNAL PLANK (LVT)	COBALT SURFACES	KATANGA	MOCHA	4MM, 12ML WEAR LAYER W/ PERFORMANCE PAD	HERRINGBONE PATTERN - 1/3 OFFSET STAGGERED (EXTEND FLOORING BELOW APPLIANCES AND CABINETS)
LVT-01	BEDROOMS	LUXURY VYNAL PLANK (LVT)	COBALT SURFACES	KATANGA	MOCHA	4MM, 12ML WEAR LAYER W/ PERFORMANCE PAD	1/3 OFFSET STAGGERED END INSTALL PATTERN (EXTEND FLOORING BELOW APPLIANCES AND CABINETS)
STONE							
ST-01	KITCHEN	QUARTZ COUNTER TOPS	MSI SURFACES	QSL-CARBREVE	CARRARA BREVE	3CM	NO OVERHANG AT KITCHENS. 12-INCH OVERHANG AT KITCHEN ISLAND SEATING LOCATION ONLY; PROVIDE EASED EDGES, 4" BACKSPLASH
ST-02	BATHROOMS	QUARTZ COUNTER TOPS	MSI SURFACES	QSL-CARBREVE	CARRARA BREVE	2CM	1/2-INCH COUNTER OVERHANG FOM FACE OF CABINET; PROVIDE 1/4-INCH COUNTER OVERHANG FROM SIDE OF END CABINET. COUNTER RETURN ON FRONT WALL (PLUMBING WALL); PROVIDE EASED EDGES, 4" BACKSPLASH
TILE							
TL-01	BATHROOM SHOWER SURROUND	7-6" CULTURED MARBLE PANEL SURROUNDED IN FAUX TILE FINISH			WHITE, GLOSSY	3X6 INCH	BASKETWEAVE PATTERN
TL-12	BATHROOM FLOOR	PORCELAIN TILE	ELM SURFACES	CLAUDE	OFF WHITE NATURAL	12" x 24"	HORIZONTAL STACK GROUT; MAPEI 02 PEWTER
TL-13	BATHROOM WET WALL & TILE BASE	PORCELAIN TILE	ELM SURFACES	GROUNDED FLUTE	MOKA MATTE	12" x 24"	HORIZONTAL STACK GROUT; MAPEI 02 PEWTER
TL-14	KITCHEN BACKSPLASH	PORCELAIN TILE	ELM SURFACES	KAGAWA	IVORY, GLOSSY	4.5" x 9"	EXTEND TO UNDERSIDE OF UPPER CABINETS HORIZONTAL STACK GROUT; MAPEI 01 ALABASTER
MILLWORK							
MW-01	KITCHEN & BATHROOM CABINETRY, BATHROOM OPEN SHELVING	PLASTIC LAMINATE	PRISM	SOPRANO	WF 341		FLAT PANEL
MW-02	KITCHEN OPEN SHELVING (ONLY)	PLASTIC LAMINATE	AGT	AGT PANEL	WHITE ACRYLIC MATTE		OPEN SHELF
WALL BASE							
WB-01	KITCHEN, LIVING, BEDROOMS	WALL BASE	VPI FLOORING	VPI LDR1 - SCULPTURED WB	67 POLARIS	4 INCH	
PAINT							
PT-01	THROUGHOUT	WALL PAINT & CEILING PAINT	PPG	N/A	1022-1 HOURGLASS		WALLS - EGGSHELL CEILING - FLAT DRYWALL - EGGSHELL TRIM - SEMI-GLOSS SOFFITS - EGGSHELL LIKE WALLS
PT-02	BEDROOM	WALL PAINT	PPG	EGGSHELL	0994-1 HIPPOPOTAMUS		TRIM & PAINT TO GO UP TO 5' AFF
PT-03	MEDIA ACCENT WALL	WALL PAINT	PPG	EGGSHELL	1033-4 LIGHT DRIZZLE		TRIM & PAINT TO MATCH DOOR...
WINDOW TREATMENT							
WT-01	LIVING ROOM	FABRIC ROLLER SHADE	TO BE BID	TO BE BID	BY I.D	CUSTOM	3% OPENNESS; MOUNTING HT & DETAIL BY I.D
WT-02	BEDROOMS	FABRIC ROLLER SHADE	TO BE BID	TO BE BID	BY I.D	CUSTOM	BLACKOUT ROLLER SHADES; MOUNTING HT & DETAIL BY I.D
UPGRADE SPECIALTY FINISHES							
SF-11	LIVING ROOM-MEDIA ACCENT WALL	PAINTED WOOD TRIM ACCENT WALL	BY GC		PT-03	HEIGHT TO MATCH BEDROOM DOORS	FIRE TREATED WOOD; 2" W x 1/2" PAINT GRADE POPLAR TRIM SPACED 24"
SF-12	NOT USED						
SF-13	NOT USED						
HARDWARE							
HW-01	UNIT ENTRY DOORS	HARDWARE LOCKSETS					
HW-02	UNIT BEDROOM DOORS	HARDWARE LOCKSETS					

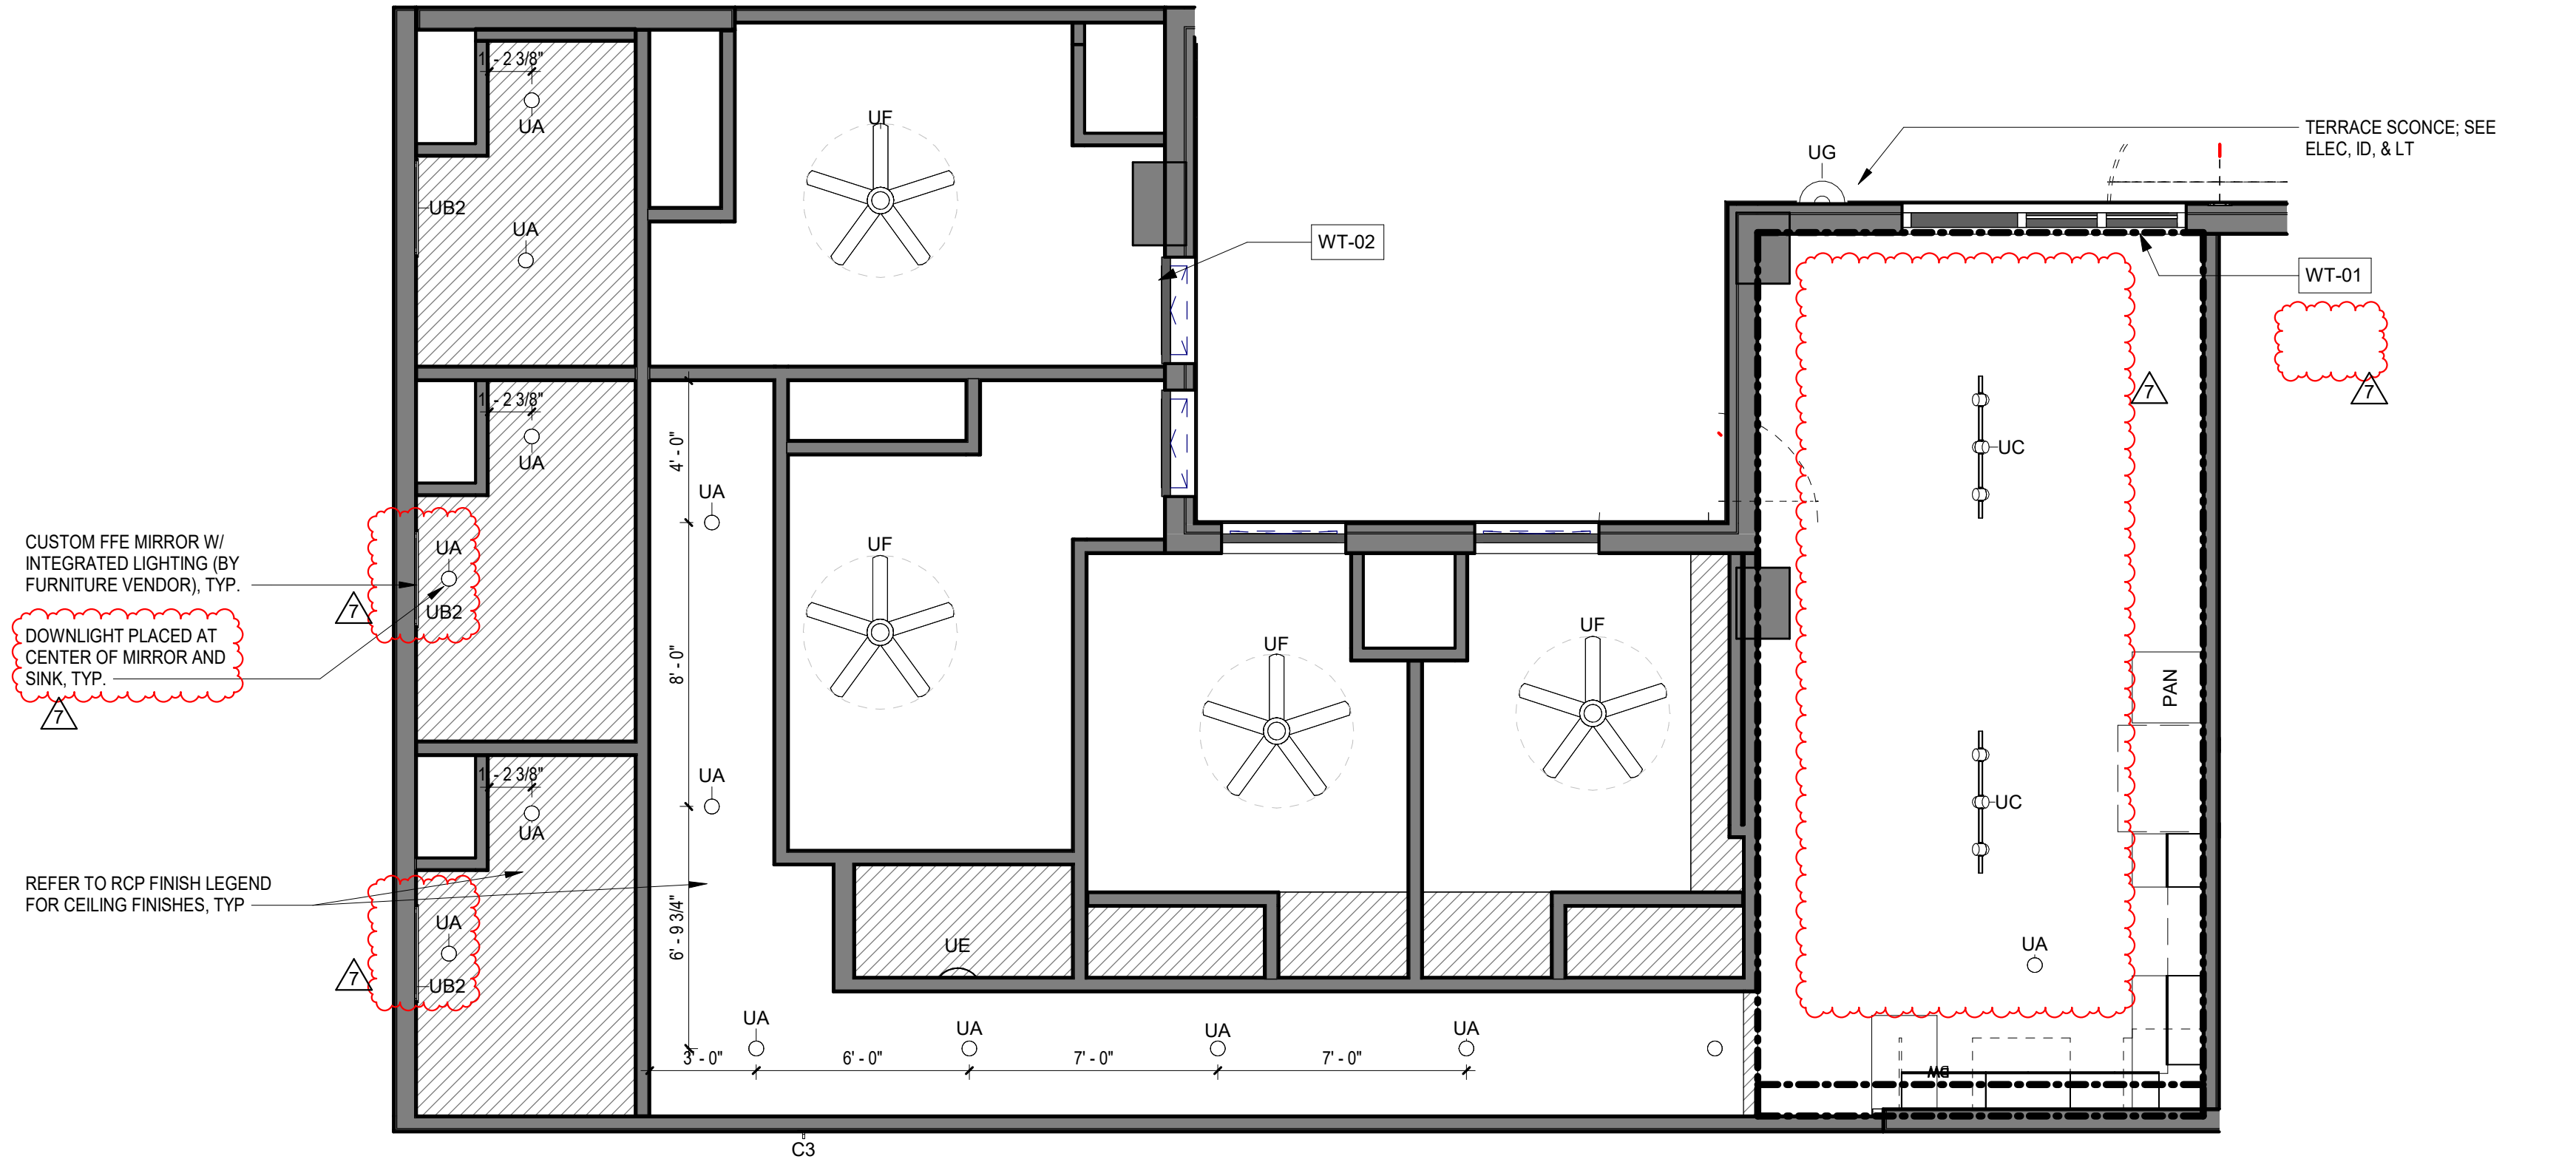


2 MANSION UNIT REFLECTED CEILING PLAN
1/4" = 1'-0"

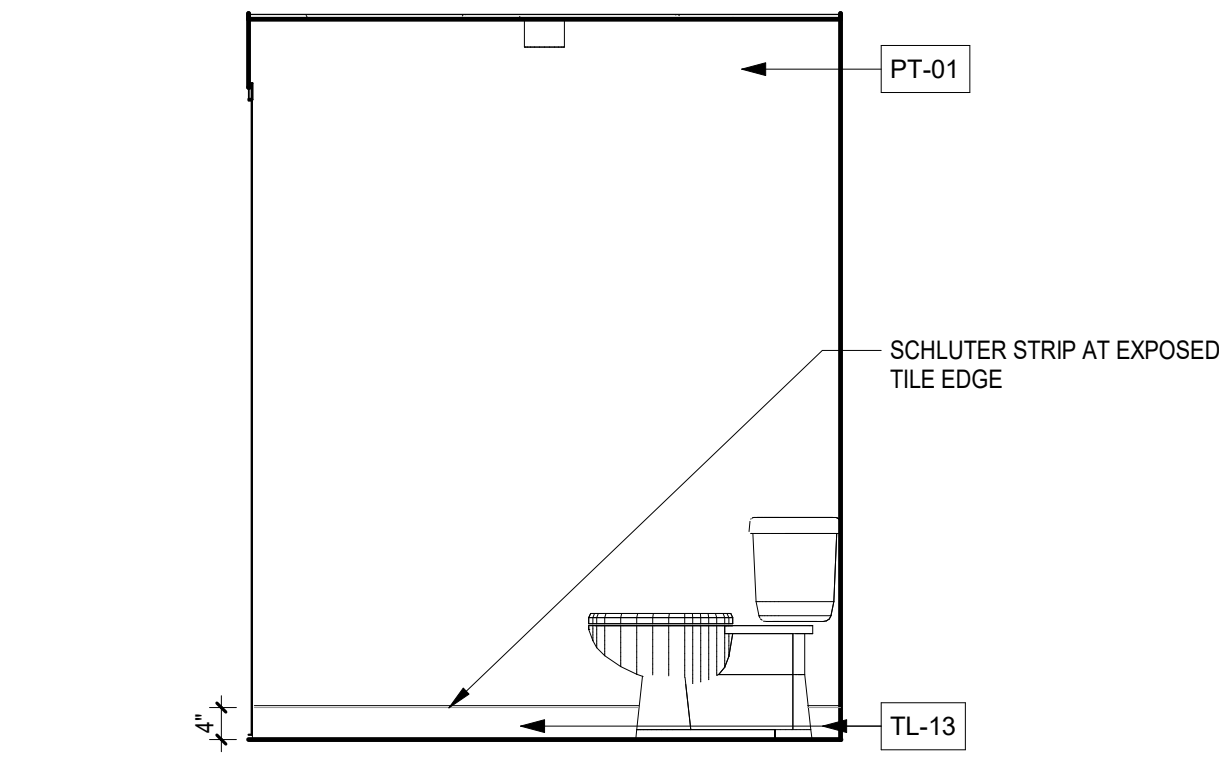


6 MANSION UPGRADE BATHROOM - SIDE ELEVATION FINISH
1/2" = 1'-0"

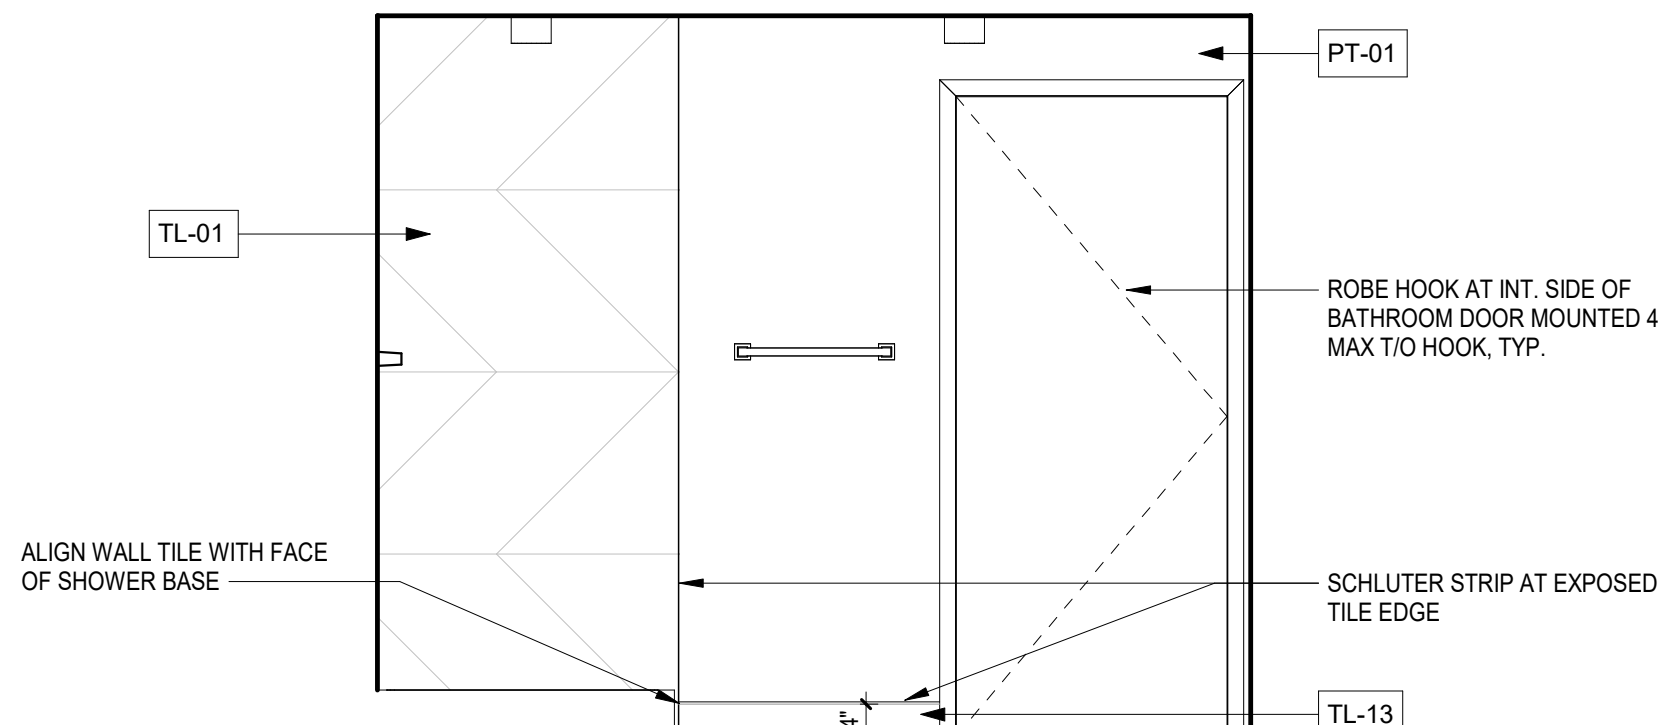


7 MANSION UPGRADE BATHROOM - FINISH ELEVATION
1/2" = 1'-0"

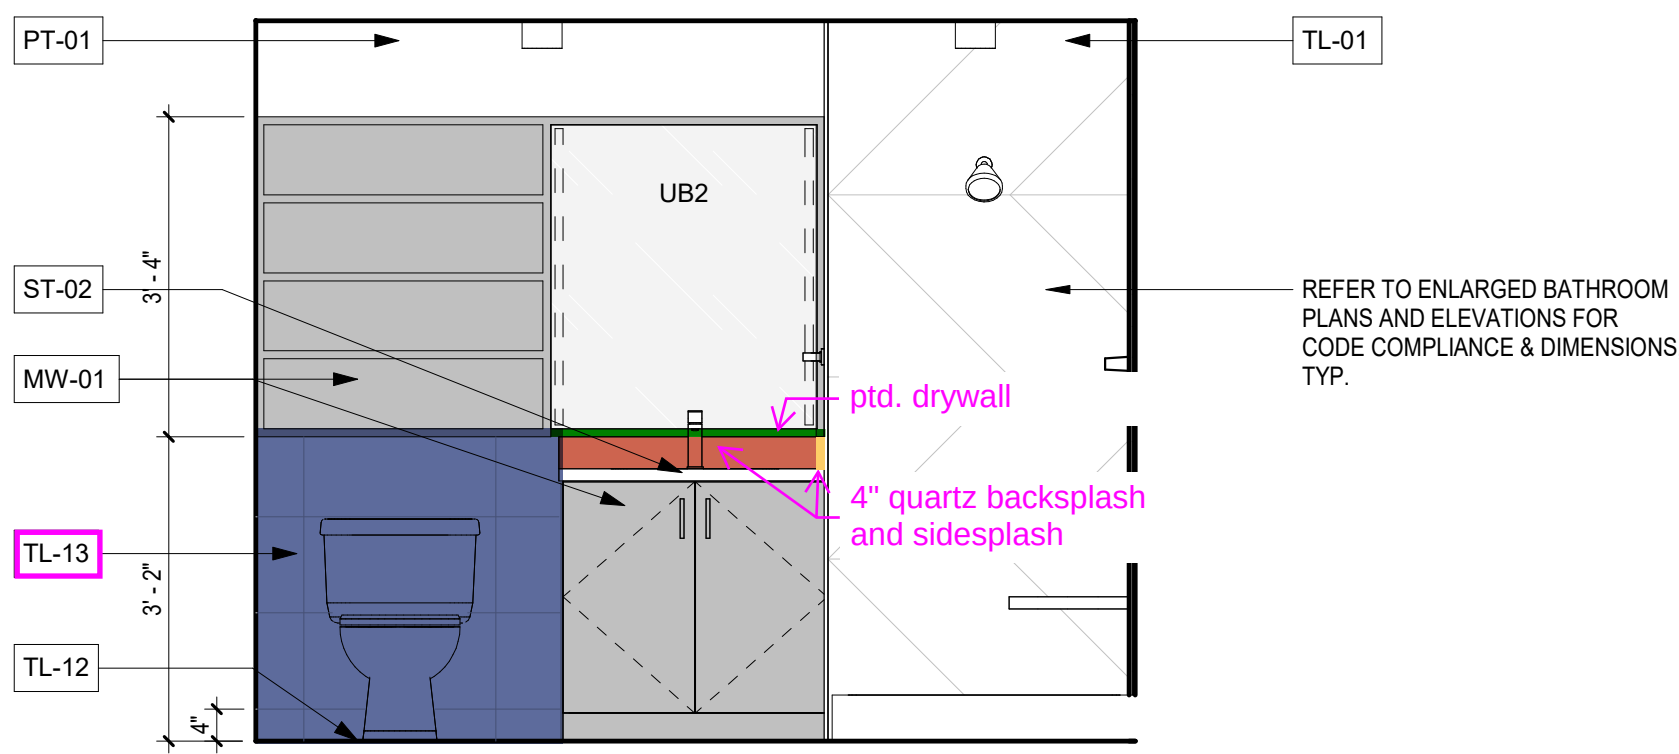


5 MANSION UPGRADE BATHROOM - VANITY ELEVATION FINISH
1/2" = 1'-0"

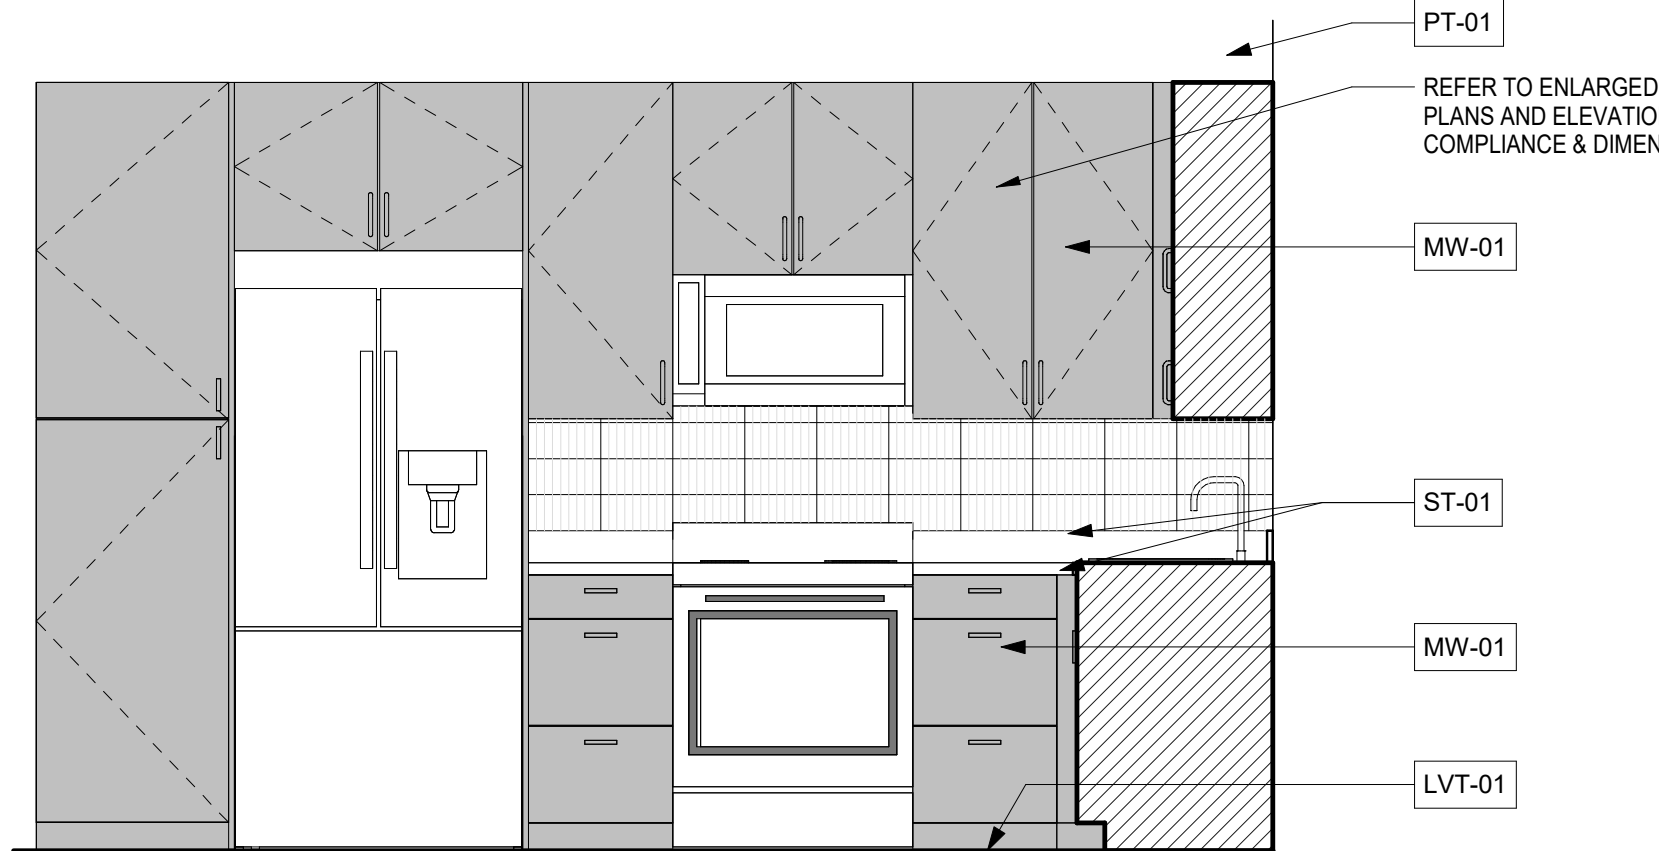

4 MANSION UPGRADE KITCHEN FINISH ELEVATION-A
1/2" = 1'-0"

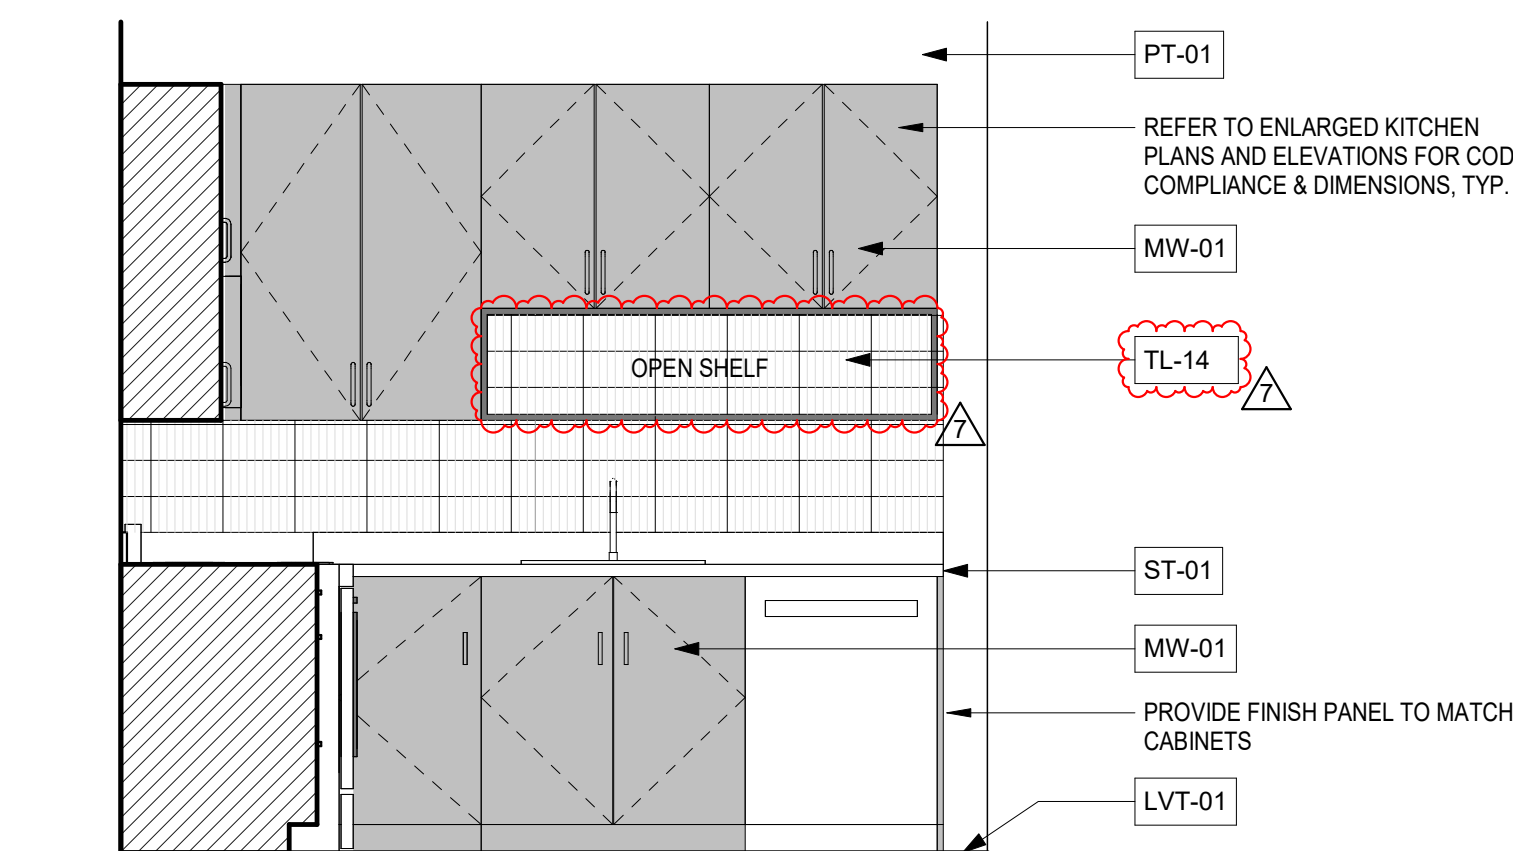

3 MANSION UPGRADE KITCHEN FINISH ELEVATION-B
1/2" = 1'-0"

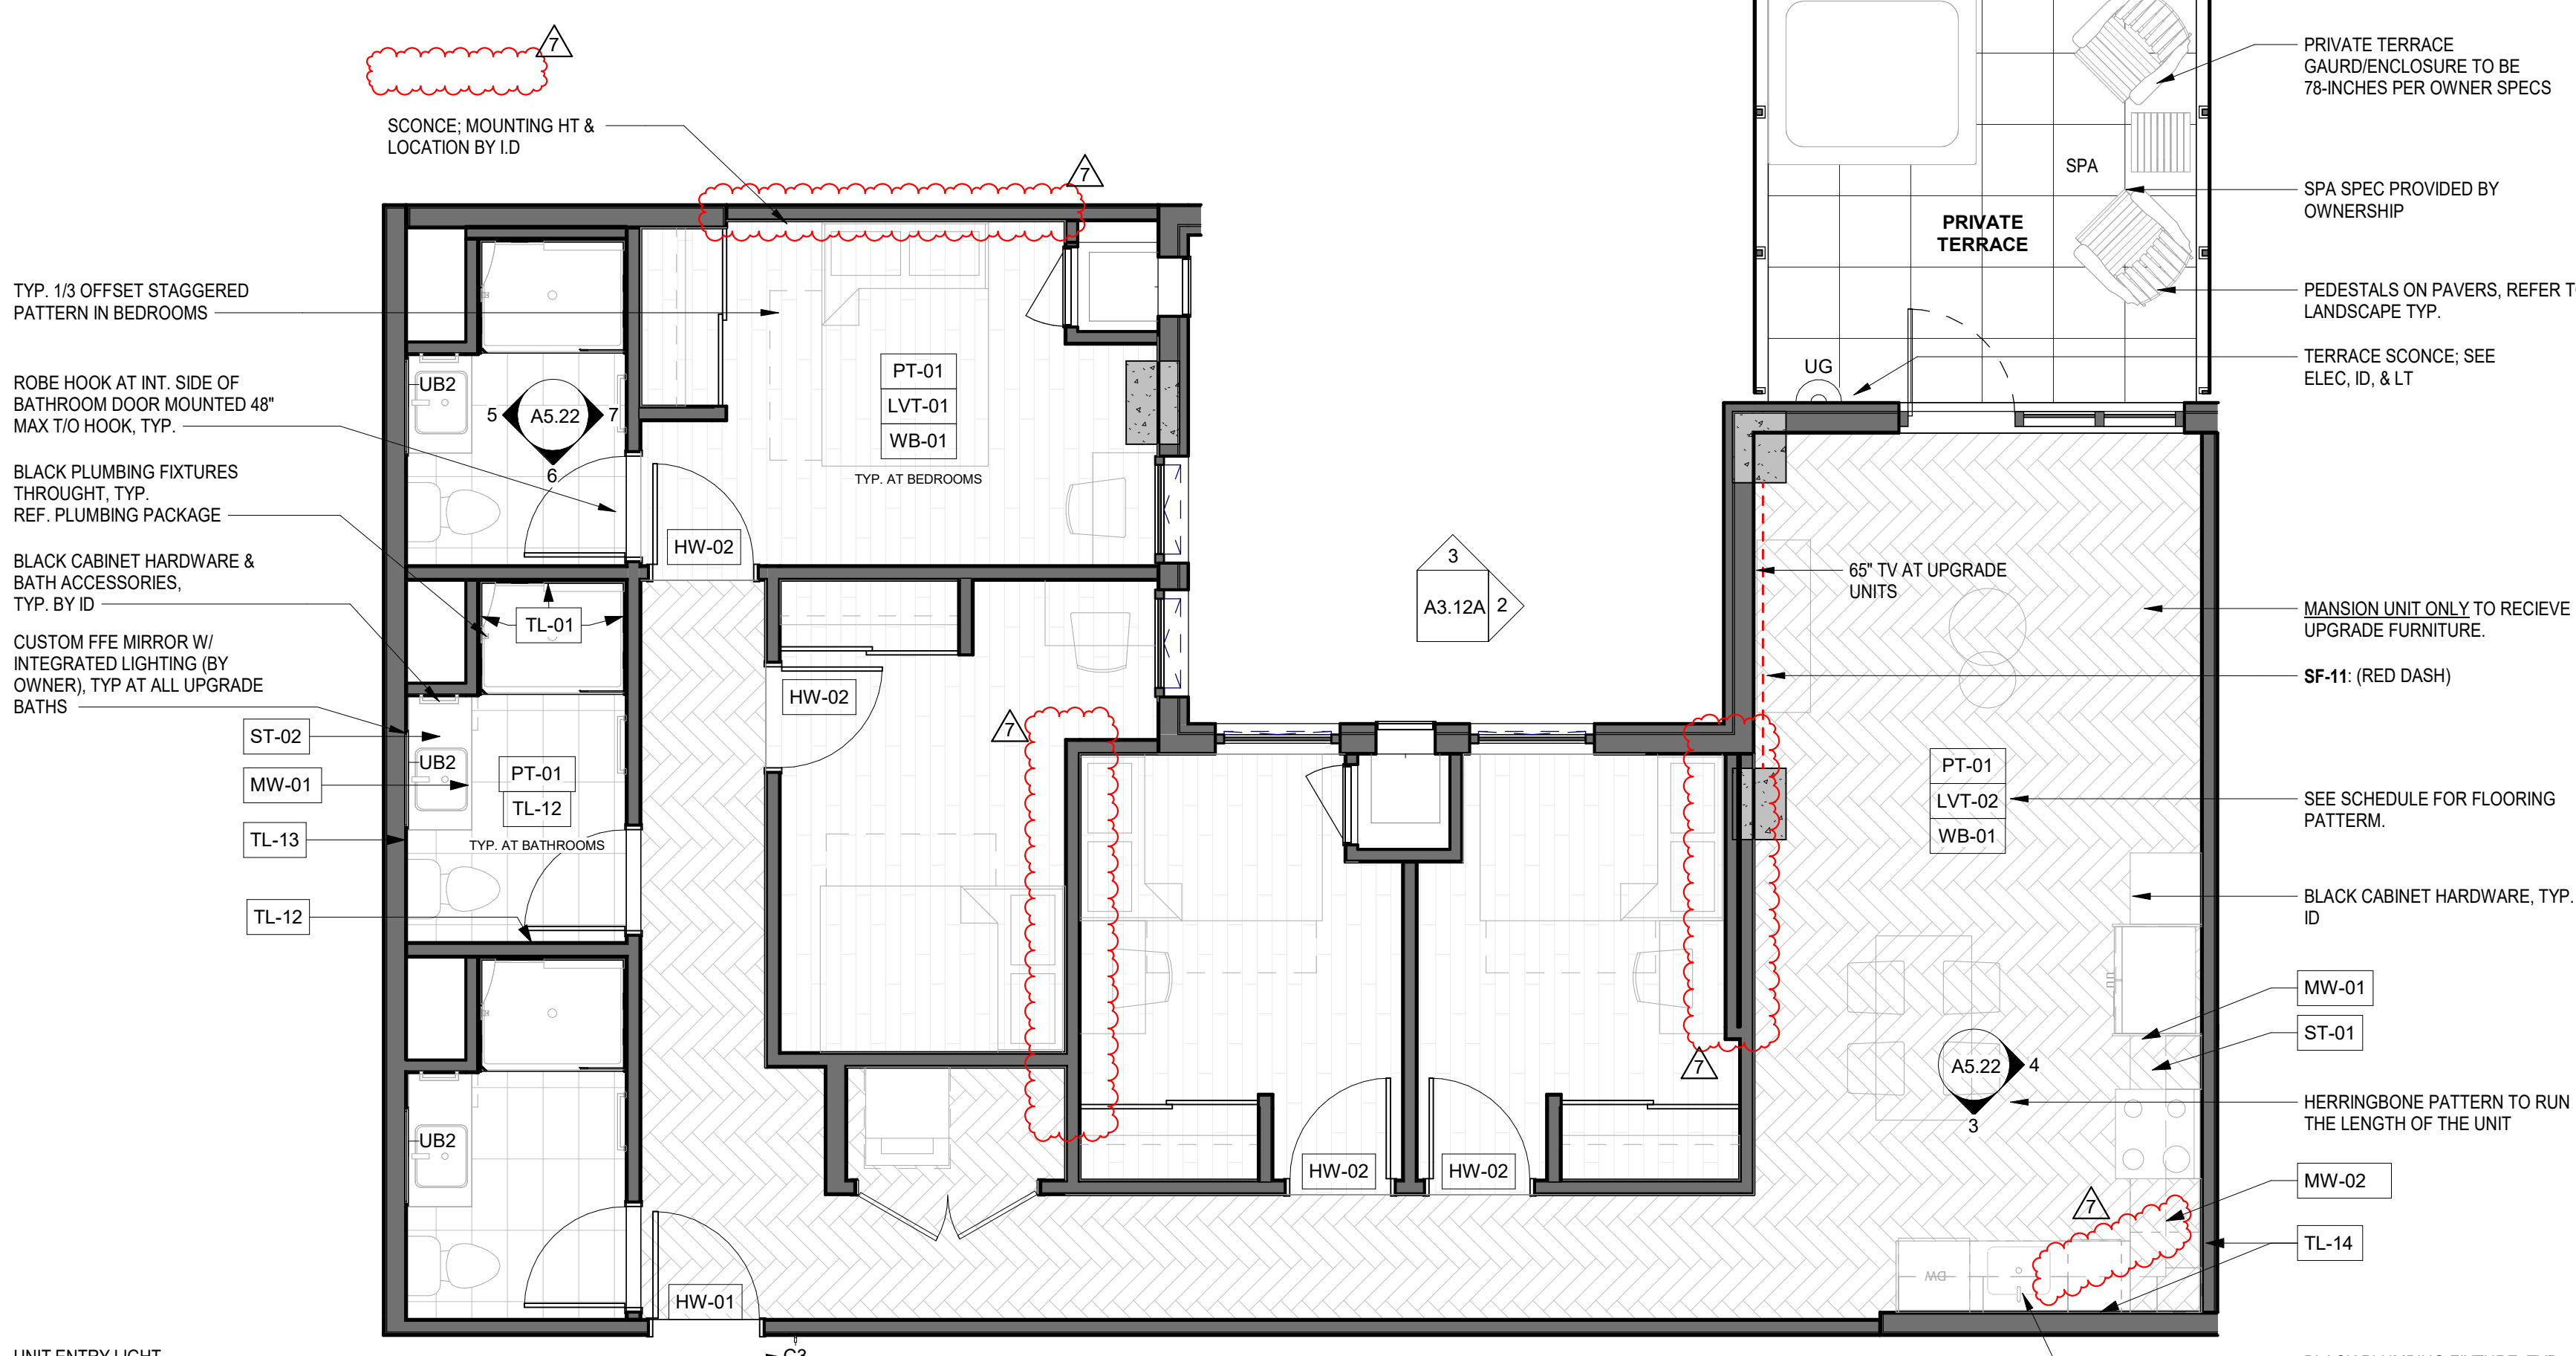

1 MANSION UNIT INTERIOR FINISH PLAN
1/4" = 1'-0"

GENERAL PLAN NOTES:

- REFER TO 00.05 FOR ACCESSIBLE MOUNTING HEIGHTS & CLEARANCES.
- REFER TO 00.03 AND 00.04 FOR ACCESSIBILITY MATRIX.
- REFER TO 01.31 FOR UPGRADE DISTRIBUTION PLANS.
- REFER TO A6 SERIES FOR ENLARGED KITCHEN & BATH PLAN ELEVATIONS.
- REFER TO INTERIOR DESIGNERS DRAWINGS & SPECIFICATIONS FOR ALL INTERIOR, UPGRADE FINISHES, HARDWARE, ACCESSORIES, ETC.
- PARTITION INFORMATION SHALL BE COORDINATED W/ SHEET A10.01.
- REFER TO 10.02 & 10.03 FOR DOOR SCHEDULE & ELEVATIONS.
- REFER TO A6.22 & A5.23 FOR ADDITIONAL UPGRADE INFORMATION.
- CONTROL S.S. OPERATING MECHANISMS, & HARDWARE INCLUDING, BUT NOT LIMITED TO, SWITCHES THAT CONTROL LIGHTING & VENTILATION & ELECTRICAL CONVENIENCE OUTLETS SHALL BE LOCATED WITHIN AN ACCESSIBLE REACH RANGE.
- FLUSH CONTROLS SHALL BE LOCATED ON THE OPEN SIDE OF THE WATER CLOSET.
- PROVIDE PIPE INSULATION / PROTECTION ACCOUNTING FOR KNEE & TOE SPACE AT ALL TYPE-A UNIT SINKS PER IBC.
- HABITABLE SPACES, OTHER THAN A KITCHEN, SHALL NOT BE LESS THAN 7'-0" IN ANY PLAN DIMENSION PER IBC.
- THERMOSTAT LOCATION & MOUNTING HTS. TO BE INSTALLED PER MECH.
- IF GAP BETWEEN FLOOR AND DOOR TRIM IS GREATER THAN 1/2" PROVIDE CAULK.
- SCHLUTER EDGE TRIM AT WALL TILE LOCATIONS.
- PRIVATE TERRACE RAILING TO BE 78" U.N.O.
- IDF CLOSETS TO BE LOCATED ON LEVELS 2, 4, 6, 8, 10, 12 AND 13 OF RESIDENTIAL FLOORS. ON ALL OTHER RESIDENTIAL FLOORS THE ROOM IS TO BE UTILIZED AS STORAGE.
- ROOMS WITH EXPOSED CONCRETE FLOOR TO BE SEALED CONCRETE.
- REFER TO SHEET 00.06 FOR FIRE EXTINGUISHER DETAILS.
- CUSTOM COLOR FACTORY PAINTED ELECTRICAL PANEL COVERS TO BE PROVIDED.

GENERAL RCP NOTES:

- LIGHTING DESIGN & SPECS. SHALL BE COORDINATED WITH ID & ELEC. DRAWINGS. DISCREPANCIES SHALL BE COORDINATED WITH THE ARCHITECT.
- GC SHALL PROVIDE THE REQUIRED STRUCTURAL DESIGN AND/OR FIRE TREATED BLOCKING PER CODE FOR ALL CEILING HUNG DEVICES, ORNAMENTAL FEATURES, TRACK FANS, ETC.
- CEILING MOUNTED FIXTURES SHALL BE CENTERED IN SPACE SERVED UNLESS NOTED OTHERWISE.
- VANITY LIGHT SHALL BE CENTERED ON VANITY. COORDINATE WITH VANITY SIZE.
- THERE SHALL BE NO EXPOSED DUCT, CONDUIT OR PIPING SYSTEMS, U.N.O.
- DEFLECTS WITHOUT DIMENSIONS THAT DO NOT ALIGN WITH WALLS ARE TO BE MINIMUM WIDTH REQUIRED FOR MEP CHASE.
- HVAC PENETRATIONS IN THE CEILING SHALL BE FIRE STOPPED & GRILLES SHALL HAVE FIRE DAMPERS.
- CENTER BATHROOM FANS ON TOILETS COORDINATE WITH MEP DRAWINGS.
- REFER TO ELECTRICAL SHEETS FOR ALL FIXTURE SELECTIONS & DESIGNATIONS.
- COORDINATE SURFACE MOUNT LIGHT FIXTURE HEIGHTS W/ ID.
- DEVICES, DIFFUSERS AND LIGHTING FIXTURES SHALL BE AXIALLY ALIGNED U.N.O.
- FIRE PROTECTION SYSTEMS SHALL BE AXIALLY ALIGNED WITH OTHER CEILING DEVICES.
- REFERENCE ALL A6 SERIES FOR OVERALL CEILING HEIGHTS & REDD INSULATION, OCCUPABLE SPACES, HABITABLE SPACES AND CORRIDORS SHALL HAVE A CEILING HEIGHT NOT LESS THAN 8'-0" AFF U.N.O. AND BATHROOMS SHALL HAVE A CEILING HEIGHT NOT LESS THAN 7'-0" AFF.
- REFER TO A2 PARTIAL PLANS & A6 PARTIAL REFLECTED CEILING PLANS FOR UNIT RCP.
- REFER TO A5 FINISH PLANS & REFLECTED CEILING PLANS FOR UPGRADE UNIT INFORMATION.
- AT LOCATIONS WHERE SOFFIT IS OVER WINDOW, SOFFIT HEIGHT TO ALIGN WITH TOP OF WINDOW.
- ACCESS PANELS TO BE PAINTED & MATCH CEILING PAINT, WHERE NEEDED.

UNIT RCP FIXTURE SYMBOL LEGEND:

TYPE MARK	DESCRIPTION
C3	TYPICAL UNIT ENTRY DOOR LIGHT
EX1	BATHROOM EXHAUST FAN, SEE MECH.
UA	5" SURFACE DOWNLIGHT
UB1	VANITY LIGHT (CENTER ON VANITY)
UB2	MIRRORLIGHT (BY OWNER) - UPGRADE UNITS ONLY
UC	4" - 0" TRACK LIGHT W/ 3 TRACK HEADS
UD	DECORATIVE PENDANT AT KITCHEN ISLAND - UDI @ STANDARD UNITS, UD2 @ UPGRADE UNITS. REFER TO A5.22 AND G1.31 FOR UPGRADE LOCATIONS
UE	W/D CLOSET LIGHT
UF	52" FANLIGHT COMBINATION
UC	EXTERIOR WALL SCONCE (8" MIN AFF)

RCP LEGEND:

	EXPOSED CONCRETE
	GY. BD. PTD. FINISH
	UPGRADED AMENITY CEILING FINISH ON DRYWALL

PLUMBING FIX. LEGEND - RESID. UNITS

TAG	DESCRIPTION
KS-1	SINGLE-BOWL UNDERMOUNT KITCHEN SINK + DUAL-SPRAY PULL-DOWN FAUCET
LAV-1	32" LAVATORY
LAV-2	45" LAVATORY
SB-01	SHOWER BASE/ 36"x48" MIN. INTERIOR CLEAR/ 6" THRESHOLD GLASS DOOR + SIDE LITE
SB-02	SHOWER BASE/ 36"x36" INTERIOR CLEAR/ 1/2" THRESHOLD GLASS DOOR. (ADA)
SB-03	SHOWER BASE/ 36"x36" MIN. INTERIOR CLEAR/ 4" THRESHOLD GLASS DOOR
SD-1	SHOWER DRAIN
SH-1	SHOWER HEAD
WC	FLOOR MOUNTED WATER CLOSET
WC-3	FLOOR MOUNTED WATER CLOSET (ADA)
WC-4	REAR EJECTOR WATER CLOSET
TUB-1	60"x32" BATH TUB
TUB-2	60"x32" BATH TUB (ADA)
** REFER TO PLUMBING FIXTURE SCHEDULE FOR SPECIFIC MANUFACTURERS AND FINISHES **	

APPLIANCE LEGEND - RESID. UNITS

TAG	DESCRIPTION
DW-1	24" W DISHWASHER, STANDARD
DW-2	24" W DISHWASHER, TYPE-A
MW-1	30" W MICROWAVE + HOOD
MW-2	22" W COUNTER MICROWAVE, TYPE-A UNITS
RNG-1	30" W RANGE + OVEN
RNG-2	30" W RANGE + OVEN, TYPE-A
REF-1	STUDIO / 18" / 26" / 3 BR / TYPE-A REFRIG. + ICE MAKER
REF-2	48" / 58" REFRIG. (ICE MAKER READY)
REF-3	UPGRADE REFRIG. + ICE MAKER & WATER DISP.
REF-4	48" TYPE-A REFRIG. + ICE MAKER??
REF-5	58" TYPE-A REFRIG. + ICE MAKER??
TV-1	TELEVISION 55"
TV-2	TELEVISION 65" - UPGRADE UNITS ONLY
UC-1	UNDER CABINET HOOD, TYPE-A UNITS
WD-1	WASHER/DRYER UNIT
WD-2	COMBO WASHER/DRYER UNIT, TYPE-A
**REFER TO CODE OUTLINE SPECIFICATIONS FOR APPLIANCE SPEC SHEETS	

General Notes:

7 12.18.25 Bulletin 6

6 09.19.25 Bulletin 5

5 06.09.25 Bulletin 4

4 04.18.25 Bulletin 3

3 03.06.25 Issued for Construction

2 12.08.24 Issued for Permit

1 11.08.24 Addendum 3

11.01.24 Issued for GMP

11.01.24 Issued for GMP

Chauncey - Tile Backsplash @ Upgrade Units

From Nishith Shah <nshah@antunovich.com>

Date Fri 11/14/2025 5:08 PM

To Chrystal Arreola <carreola@corespaces.com>; Samantha Plessinger <splessinger@powerconstruction.net>

Cc Michael Bolatto <mbolatto@corespaces.com>

 1 attachment (5 MB)

IMG_3491.JPG;

CAUTION EXTERNAL!

Sam,

See attached photo of an upgrade bathroom where the backsplash and side splash will be tile and not quartz.



thanks

Nishith Shah, AIA NCARB
Associate Principal

ANTUNOVICH ASSOCIATES

Architecture • Planning • Interior Design

224 West Huron Street, Suite 7E

Chicago, Illinois 60654

Main: [312.266.1126](tel:312.266.1126)

Direct: [312.573.6113](tel:312.573.6113)

Mobile: [773.970.0876](tel:773.970.0876)

nshah@antunovich.com

www.antunovich.com

cloud.antunovich.com

CAUTION: This email originated from outside of the organization. Do not click links or open attachments unless you recognize the sender and know the content is safe. Please report all suspicious emails using the Report Phishing button in Outlook.

Change Order Request

PCI-0053 - AMS FP COR #015

March 27, 2026

AMS FP Project No: 29602

PC Treehouse LLC

8750 W Bryn Mawr Avenue, Suite 500
Chicago, IL 60631

Attn: Andy Rodawold

Mobile: (815) 278-1682

arodawold@poerconstruction.net

Re: **5642002 Core Spaces - HUB Chauncey**

135 S Chauncey Avenue, West Lafayette, IN 47906

Mr. Rodawold:

AMS Industries, Inc. has received **PCI-0053 Bulletin 07 dated 3/6/26** and submit the following pricing to accommodate the design changes for the fire protection scope of work. Various ceilings were added / changed on Levels 2-13.

Pricing for this COR: **\$ 51,483.00**

- **Updated CAD Files are to be provided for shop drawings background modifications**
- This change carries a schedule impact of (10) Days.
- Lead Time and Delivery (0) Days
- **See attached backup and overlays of Floors L2-L13**

<\$1,616> for x69 L3-L11
Total = \$49,867

Respectfully submitted,

AMS Industries, Inc.

George V Anadiotis

George V Anadiotis
Sr Fire Protection Account Manager

ganadiotis@ams-pmt.com

AMS Mechanical Systems, Inc.
9341 Adam Don Parkway
Woodridge, IL 60517

Phone: (630) 887 - 7700

24 - Hour: (800) 794 - 5033

AMS FP Change Order Request # COE 015

Project: HUB Chauncey
AMS FP Project Number: 29602

Date: March 27, 2026

Description of Work: PCI-0053 Bulletin 07 - Various Ceiling Changes L2-L13

\\Users\ganadiotis\Desktop\Change Orders\29602 HUB Chauncey\COR-015 PCI-0053 Bulletin 07\29602 HUB Chauncey - AMS FP COE 015 PCI-0053 03.27.26.xls

Description	Qty.	Price per Unit	Extended Price	Labor per Unit	Extended Labor		
New - 1/2" WHT CONCEALED	62	81.25	5,037.50			Total Material Cost:	11,051.00
New - 1" HANGER ASSEMBLY	62	7.47	463.14			Sales Tax: 7.00%	774.00
New - STRAIGHT NIPPLE	188	17.68	3,323.84			Total Material Cost:	11,825.00
New - ARM OVER	62	35.91	2,226.42				
Subtotals:			11,050.90				
Hourly Costs							
DESIGN	40	85.00	3,400.00			Net Labor Hours: 2J 1F	224.00
Total Hourly Cost:			3,400.00			Labor Cost Per Hour: 140.967	Blend - No GL
						Total Labor Cost:	31,577.00
						Total Costs:	46,802.00
						Overhead: 0%	0.00
						Subtotal:	46,802.00
						Profit: 10%	4,681.00
						Quoted Price:	\$51,483.00

RFI-592 L02 RCP for Record Sheets
RFI-611 Upgrade Units RCP Updates based on Added Track Lights and Soffits
RFI-626 L02 - Unit 248, 246, and 229 - Upgrade Track Light Ceiling
RFI-585 Unit X69 stack hallway ceiling clarification
RFI-574 L02 and L03-L11 RCP Sheets
RFI-591 L03-L11 RCP Sheets

Quoted Price: \$51,483.00

A6.05A	Level 02	Unit 213 - RFI 592	Lower 1 Sidewall	✓ OK	A6.15A	Level 12	Unit 1213 - RFI 611	Lower 2 Sidewalls	✓ OK
		Unit 213 - RFI 611	Lower 2 Sidewalls				Unit 1214 - RFI 611	Lwr 2 Side Add 1 P	
		Unit 225 - RFI 611	Lower 1 Sidewall				Unit 1215 - RFI 611	Add 4 Pendants	
A6.05B	Level 02	Unit 206 - RFI 592	Lower 2 Sidewalls	✓ OK			Unit 1216 - RFI 611	Lower 2 Sidewalls	
		Unit 206 - RFI 611	Lower 2 Sidewalls				Unit 1218 - RFI 611	Lower 2 Sidewalls	
		Unit 212 - RFI 611	Lower 2 Sidewalls				Unit 1218 - RFI 611	Add 2 Pendants	
		Unit 226 - RFI 611	Lower 2 Sidewalls				Unit 1219 - RFI 611	Lower 2 Sidewalls	
		Unit 228 - RFI 611	Lower 2 Sidewalls				Unit 1222 - RFI 611	Add 1 Pendant	
		Unit 229 - RFI 592	Lower 1 Sidewall				Unit 1225 - RFI 611	Lwr 1 Side Add 1 P	
A6.05C	Level 02	Unit 231 - RFI 611	Lower 2 Sidewalls	✓ OK	A6.15B	Level 12	Unit 1205 - RFI 611	Add 2 Pendants	✓ OK
		Unit 232 - RFI 611	Lower 2 Sidewalls				Unit 1206 - RFI 611	Lower 2 Sidewalls	
		Unit 235 - RFI 592	Lower 1 Sidewall				Unit 1208 - RFI 611	Lwr 2 Side Add 1 P	
		Unit 236 - RFI 611	Lower 1 Sidewall				Unit 1209 - RFI 611	Add 2 Pendant	
		Unit 237 - RFI 611	Lower 1 Sidewall				Unit 1210 - RFI 611	Lower 1 Sidewall	
		Unit 246 - RFI 626	Lower 2 Sidewalls				Unit 1212 - RFI 611	Lower 2 Sidewalls	
		Unit 248 - RFI 611	Lower 2 Sidewalls				Unit 1226 - RFI 611	Lower 2 Sidewalls	
A6.05D	Level 02	Unit 238 - RFI 592	Lower 1 Sidewall	✓ OK			Unit 1227 - RFI 611	Add 3 Pendants	
		Unit 239 - RFI 592	Lower 1 Sidewall				Unit 1228 - RFI 611	Lower 2 Sidewalls	
		Unit 239 - RFI 585	Lower 1 Sidewall				Unit 1229 - RFI 611	Lower 2 Sidewalls	
		Unit 240 - RFI 592	Lower 3 Sidewalls				Unit 1230 - RFI 611	Add 3 Pendants	
		Unit 268 - RFI 592	Lower 1 Sidewall		A6.15C	Level 12	Unit 1201 - RFI 611	Relo 1 Side Add 2 P	✓ OK
		Unit 269 - RFI 592	Lower 1 Sidewall				Unit 1202 - RFI 611	Add 2 Pendants	
		Unit 272 - RFI 592	Lower 2 Sidewalls				Unit 1204 - RFI 611	Add 2 Pendants	
A6.06A	L3-L11	Unit x18 - RFI 591	Lower 2 Sidewalls	✓ OK			Unit 1231 - RFI 611	Lower 2 Sidewalls	
							Unit 1232 - RFI 611	Lower 3 Sidewalls	
A6.06D	L3-L11	Unit x39 - RFI 591	Lower 1 Sidewall	✓ OK			Unit 1234 - RFI 611	Lower 2 Sidewalls	
		Unit x69 - RFI 585	Lower 2 Pendants				Unit 1235 - RFI 611	Relo 1 Side Add 2 P	
		Unit x72 - RFI 591	Lower 1 Sidewalls				Unit 1236 - RFI 611	Lower 1 Sidewall	

Added ceiling in 239 issued in RFI-574 and updated with ceiling height in RFI 591

History of RCP Plans:
Sheet A6.05D L2-12 RCP GMP - ceiling
Sheet A6.05D L2-12 RCP Bulletin 05 - ceiling
Sheet A6.05D L2-12 RCP Bulletin 06 - no ceiling
Sheet A6.06D L3-11 RCP Bulletin 07 - new sheet in issuance, added back in ceiling

A6.15C	Level 12	Unit 1244 - RFI 611	Lower 1 Sidewall	✓ OK
		Unit 1245 - RFI 611	Relo 1 Side Add 2	
		Unit 1246 - RFI 611	Lower 2 Sidewalls	
		Unit 1248 - RFI 611	Lower 1 Sidewall	
A6.15D	Level 12	Unit 1238 - RFI 611	Lower 2 Sidewalls	✓ OK
		Unit 1239 - RFI 611	Lower 2 Sidewalls	
		Unit 1240 - RFI 611	Lower 2 Sidewalls	
		Unit 1241 - RFI 611	Relo 1 Side Add 2	
		Unit 1242 - RFI 611	Lower 2 Sidewalls	
		Unit 1261 - RFI 611	Lower 1 Sidewall	
		Unit 1262 - RFI 611	Lower 1 Sidewall	
		Unit 1263 - RFI 611	Relo 1 Side Add 2	
		Unit 1266 - RFI 611	Add 2 Pendent	
		Unit 1269 - RFI 611	Lower 1 Sidewall	
		Unit 1272 - RFI 611	Lower 2 Sidewalls	
A6.16A	Level 13	Unit 1313 - RFI 611	Lower 2 Sidewalls	✓ OK
		Unit 1314 - RFI 611	Lwr 3 Side Add 1 P	
		Unit 1315 - RFI 611	Lower 1 Sidewall	
		Unit 1316 - RFI 611	Lwr 2 Side Add 1 P	
		Unit 1318 - RFI 611	Lower 2 Sidewalls	
		Unit 1319 - RFI 611	Lwr 2 Side Add 1 P	
		Unit 1320 - RFI 611	Lwr 1 Side Add 1 P	
		Unit 1321 - RFI 611	Lwr 1 Side Add 1 P	
		Unit 1322 - RFI 611	Lwr 1 Side Add 1 P	
		Unit 1323 - RFI 611	Lwr 2 Side Add 1 P	
		Unit 1324 - RFI 611	Lower 2 Sidewalls	
		Unit 1325 - RFI 611	Lower 2 Sidewalls	
A6.16B	Level 13	Unit 1305 - RFI 611	Lower 1 Sidewall	✓ OK
		Unit 1306 - RFI 611	Lower 2 Sidewalls	
		Unit 1307 - RFI 611	Lwr 1 Side Add 2 P	
		Unit 1308 - RFI 611	Lwr 2 Side Add 1 P 1 S	
		Unit 1309 - RFI 611	Lwr 1 Side Add 3 P	
		Unit 1310 - RFI 611	Lower 1 Sidewall	
		Unit 1311 - RFI 611	Lower 1 Sidewall	
		Unit 1312 - RFI 611	Lower 2 Sidewalls	
		Unit 1326 - RFI 611	Lower 2 Sidewalls	
		Unit 1327 - RFI 611	Lwr 2 Side Add 3 P	
		Unit 1328 - RFI 611	Lower 2 Sidewalls	
		Unit 1329 - RFI 611	Lower 2 Sidewalls	
		Unit 1330 - RFI 611	Lwr 2 Side Add 3 P	
A6.16C	Level 13	Unit 1302 - RFI 611	Lwr 1 Side Add 2 P	✓ OK
		Unit 1303 - RFI 611	Lwr 1 Side Add 2 P	
		Unit 1304 - RFI 611	Lwr 1 Side Add 2 P	
		Unit 1331 - RFI 611	Lower 2 Sidewalls	



LABOR RATES

CRAFT: SPRINKLER FITTERS

EFFECTIVE DATES:

LOCAL: 281 ILLINOIS

JUNE 1, 2025 TO MAY 31, 2026

LABOR CLASSIFICATION:			JOURNEYMAN 25/26			FOREMAN 25/26			GENERAL FOREMAN 25/26		
			S.T.	1+1/2	D.T	S.T.	1+1/2	D.T	S.T.	1+1/2	D.T
1 BASE WAGE			\$64.35	\$96.53	\$128.70	\$67.10	\$100.65	\$134.20	\$67.35	\$101.03	\$134.70
2 FRINGE BENEFITS											
--HEALTH & WELFARE			\$14.95	\$14.95	\$14.95	\$14.95	\$14.95	\$14.95	\$14.95	\$14.95	\$14.95
--INDUSTRY PENSION FUND			\$7.30	\$7.30	\$7.30	\$7.30	\$7.30	\$7.30	\$7.30	\$7.30	\$7.30
--SUPPLEMENTAL PENSION FUND			\$12.00	\$12.00	\$12.00	\$12.00	\$12.00	\$12.00	\$12.00	\$12.00	\$12.00
--UNION PROTECTION FUND			\$4.41	\$4.41	\$4.41	\$4.41	\$4.41	\$4.41	\$4.41	\$4.41	\$4.41
--LMCC			\$0.05	\$0.05	\$0.05	\$0.05	\$0.05	\$0.05	\$0.05	\$0.05	\$0.05
--INTL TRAINING / LMCC			\$0.10	\$0.10	\$0.10	\$0.10	\$0.10	\$0.10	\$0.10	\$0.10	\$0.10
--PROMOTION FUND			\$0.70	\$0.70	\$0.70	\$0.70	\$0.70	\$0.70	\$0.70	\$0.70	\$0.70
--APPRENTICE TRAINING FUND			\$1.00	\$1.00	\$1.00	\$1.00	\$1.00	\$1.00	\$1.00	\$1.00	\$1.00
3 PAYROLL TAXES:											
--FUTA			0.60% OF BASE RATE			\$0.39	\$0.58	\$0.77	\$0.40	\$0.61	\$0.81
--SUTA			8.65% OF BASE RATE			\$5.57	\$8.35	\$11.13	\$5.80	\$8.71	\$11.61
--FICA			6.20% OF BASE RATE			\$3.99	\$5.98	\$7.98	\$4.16	\$6.24	\$8.32
MEDICARE			1.45% OF BASE RATE			\$0.93	\$1.40	\$1.87	\$0.97	\$1.46	\$1.95
4 INSURANCE											
WC			ONLY			\$5.89	\$5.89	\$5.89	\$6.14	\$6.14	\$6.14
GL			CCIP - Remove			\$0.00	\$0.00	\$0.00	\$0.00	\$0.00	\$0.00
5 SUPERINTENDENT						\$6.19	\$6.19	\$6.19	\$6.19	\$6.19	\$6.19
6 TRUCK / TOOLS						\$12.00	\$12.00	\$12.00	\$12.00	\$12.00	\$12.00
7 COST RATE						\$139.81	\$177.43	\$215.04	\$143.28	\$182.50	\$221.72
8 OVERHEAD/PROFIT 10% - MARGIN						\$15.53	\$19.71	\$23.89	\$15.92	\$20.28	\$24.64
9 TOTAL BILLING RATE PER HOUR						\$155.35	\$197.14	\$238.93	\$159.20	\$202.78	\$246.35